






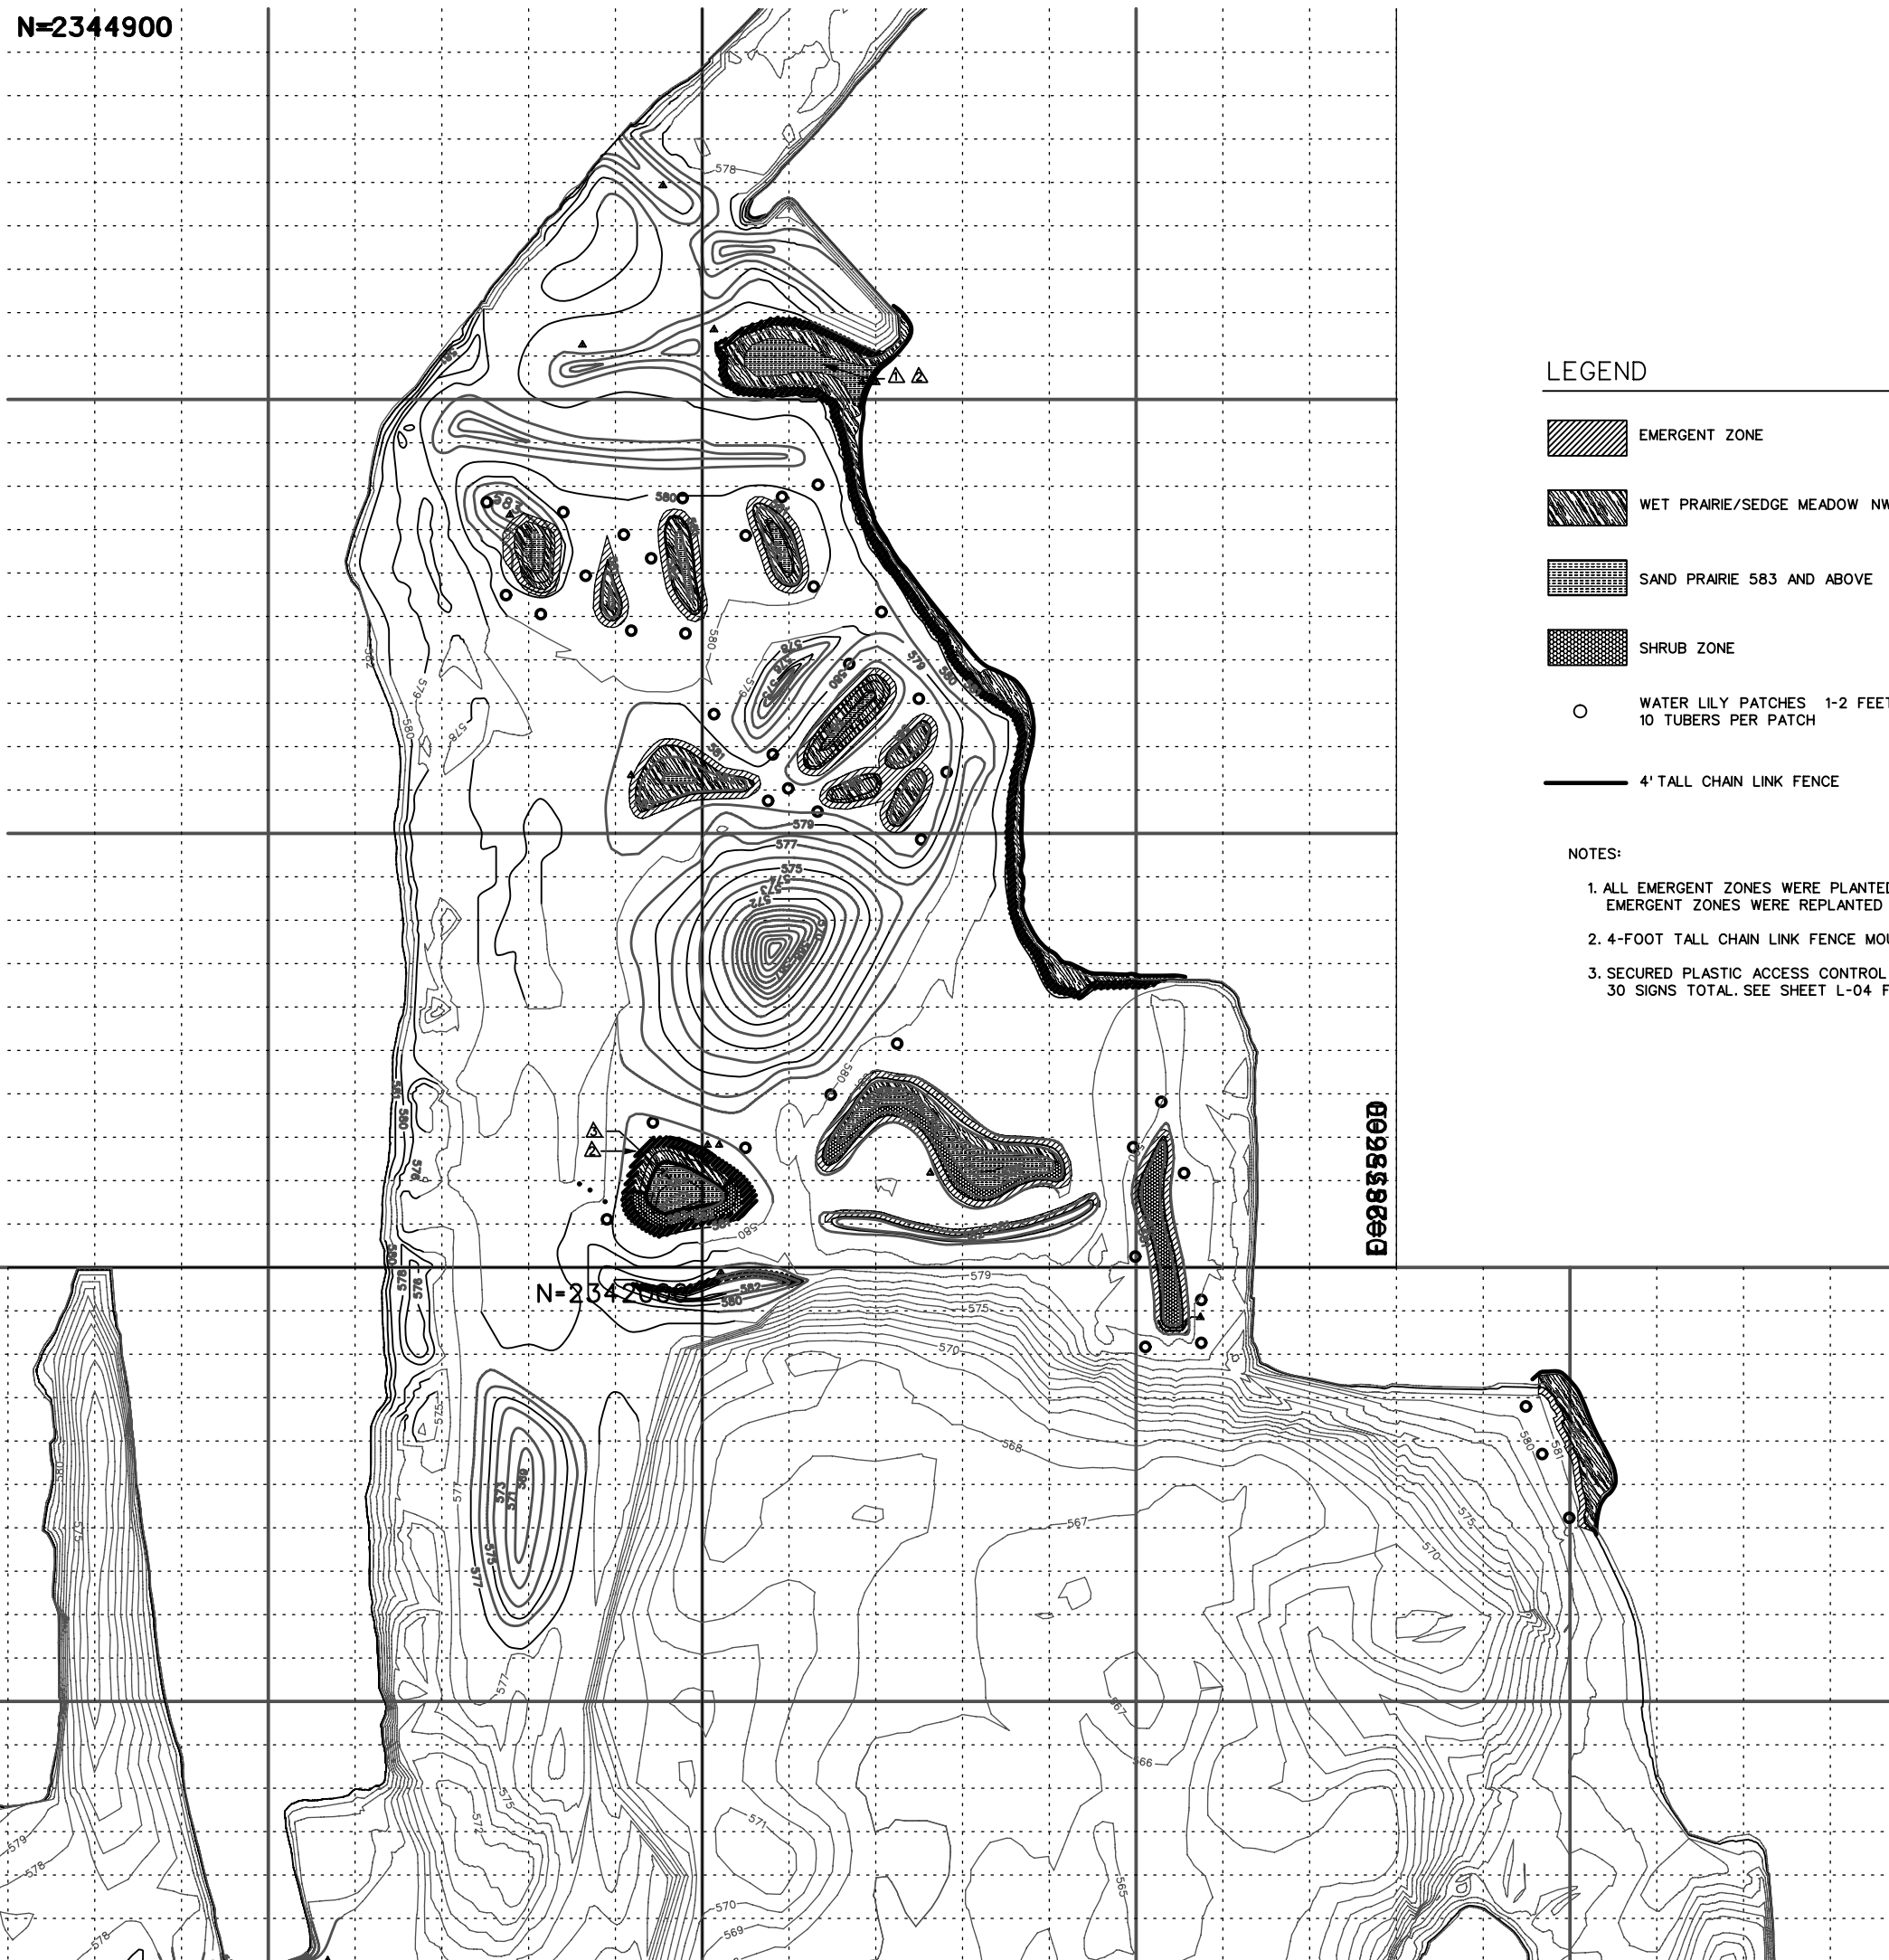

N=2344900

N=2342000

N=2340400




LEGEND

-  EMERGENT ZONE
-  WET PRAIRIE/SEDGE MEADOW NWL - 581.7 TO 583
-  SAND PRAIRIE 583 AND ABOVE
-  SHRUB ZONE
-  WATER LILY PATCHES 1-2 FEET DEEP
10 TUBERS PER PATCH
-  4' TALL CHAIN LINK FENCE

NOTES:

1. ALL EMERGENT ZONES WERE PLANTED 15 FEET WIDE IN POOL #8. EMERGENT ZONES WERE REPLANTED IN POOLS #6, #7 AT 5 FEET WIDE.
2. 4-FOOT TALL CHAIN LINK FENCE MOUNTED TO 5-FOOT TALL STEEL PIPE POSTS SPACED EVERY 10 FEET.
3. SECURED PLASTIC ACCESS CONTROL SIGNS TO CONSTRUCTION FENCE WITH PLASTIC TIES EVERY 100 FEET. 30 SIGNS TOTAL. SEE SHEET L-04 FOR DETAILS.

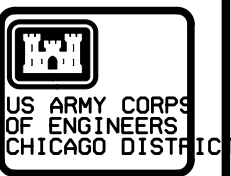

SYMBOL	AMENDMENT DESCRIPTION	DATE APPROVED	SYMBOL	DESCRIPTION	DATE APPROVED
▲	AD0001-TOLL ROAD CONCRETE REMOVAL				
▲	AD0002-AREA #32 CUT & RECONFIGURATION OF POOL #8				
▲	AD0003-SAND PRAIRIE FABRIC AND WATERING				
▲	AD0004-REPLANT EMERGENT ZONE POOL #6, #7				


DESIGNED BY: AS	DATE: JULY 2005
DRAWN BY: CC	SCALE: AS SHOWN
CHECKED BY: RR	CONTRACT NUMBER: W912P6-05-C-0012
SUBMITTED BY:	DATE:

U.S. ARMY ENGINEER DISTRICT
CORPS OF ENGINEERS
CHICAGO, ILLINOIS

Tetra Tech EM Inc.
Chicago, Illinois

WOLF LAKE
HAMMOND, INDIANA
AQUATIC ECOSYSTEM RESTORATION
PROJECT SITE
PROPOSED PLANTING PLAN
POOLS 7, 8, AND 9

SHEET REFERENCE NUMBER:
L-01
SHEET 54 OF 57

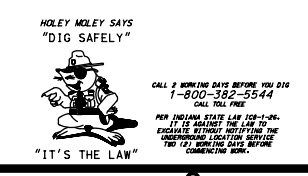

AS-BUILT
SCALE
1" = 200'

DRAWING INDEX

		N2347800
	A	N2344900
	B	N2342000
	C	N2340400
F	G	N2338800
H	I	N2337200
J	K	N2335600

N=2340400

N=2340400

N=2338800

N=2338800

N=2337200

N=2337200

0000000000






0000000000

0000000000



SYMBOL	AMENDMENT	DESCRIPTION	DATE	APPROVED SYMBOL	DATE	APPROVED
▲	AM0001	TOLL ROAD CONCRETE REMOVAL				
▲	AM0002	AREA 12 CUT & RECONFIGURATION OF POOL 18				
▲	AM0003	SAND PRAIRIE FABRIC AND WATERING				
▲	AM0004	REPLANT EMERGENT ZONES POOL #4/7				

LEGEND

-  EMERGENT ZONE
-  WET PRAIRIE/SEDGE MEADOW NWL - 581.7 TO 583
-  SAND PRAIRIE 583 AND ABOVE
-  SHRUB ZONE
-  WATER LILY PATCHES 1-2 FEET DEEP
10 TUBERS PER PATCH

NOTE:
 ALL EMERGENT ZONES WERE PLANTED 15 FEET WIDE IN POOL 8
 REPLANTING OF EMERGENT ZONES IN POOLS
 6 AND 7 WERE AT 5 FEET.

DESIGNED BY: AS	DATE: JULY 2005
DRAWN BY: CC	SCALE: AS SHOWN
CHECKED BY: RR	CONTRACT NUMBER: W912P6-05-C-0012
SUBMITTED BY:	DATE:


U.S. ARMY ENGINEER DISTRICT
 CORPS OF ENGINEERS
 CHICAGO, ILLINOIS

Tetra Tech EM Inc.
 Chicago, Illinois

**WOLF LAKE
 HAMMOND, INDIANA
 AQUATIC ECOSYSTEM RESTORATION
 PROJECT SITE
 PROPOSED PLANTING PLAN
 POOLS 7, 8, AND 9**

**SHEET
 REFERENCE
 NUMBER:
 L-02**

SHEET 55 OF 57

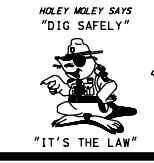

CALL A MONITORING DATE BEFORE YOU DIG
 1-800-367-5544
 CALL TOLL FREE

FOR INQUIRY PLEASE CALL 1-800-367-5544
 FOR INFORMATION ON THE STATE OF ILLINOIS
 ENVIRONMENTAL PROTECTION ACT, VISIT THE
 WWW.ILSTATE.GOV WEBSITE

AS-BUILT
 SCALE
 1" = 200'

